
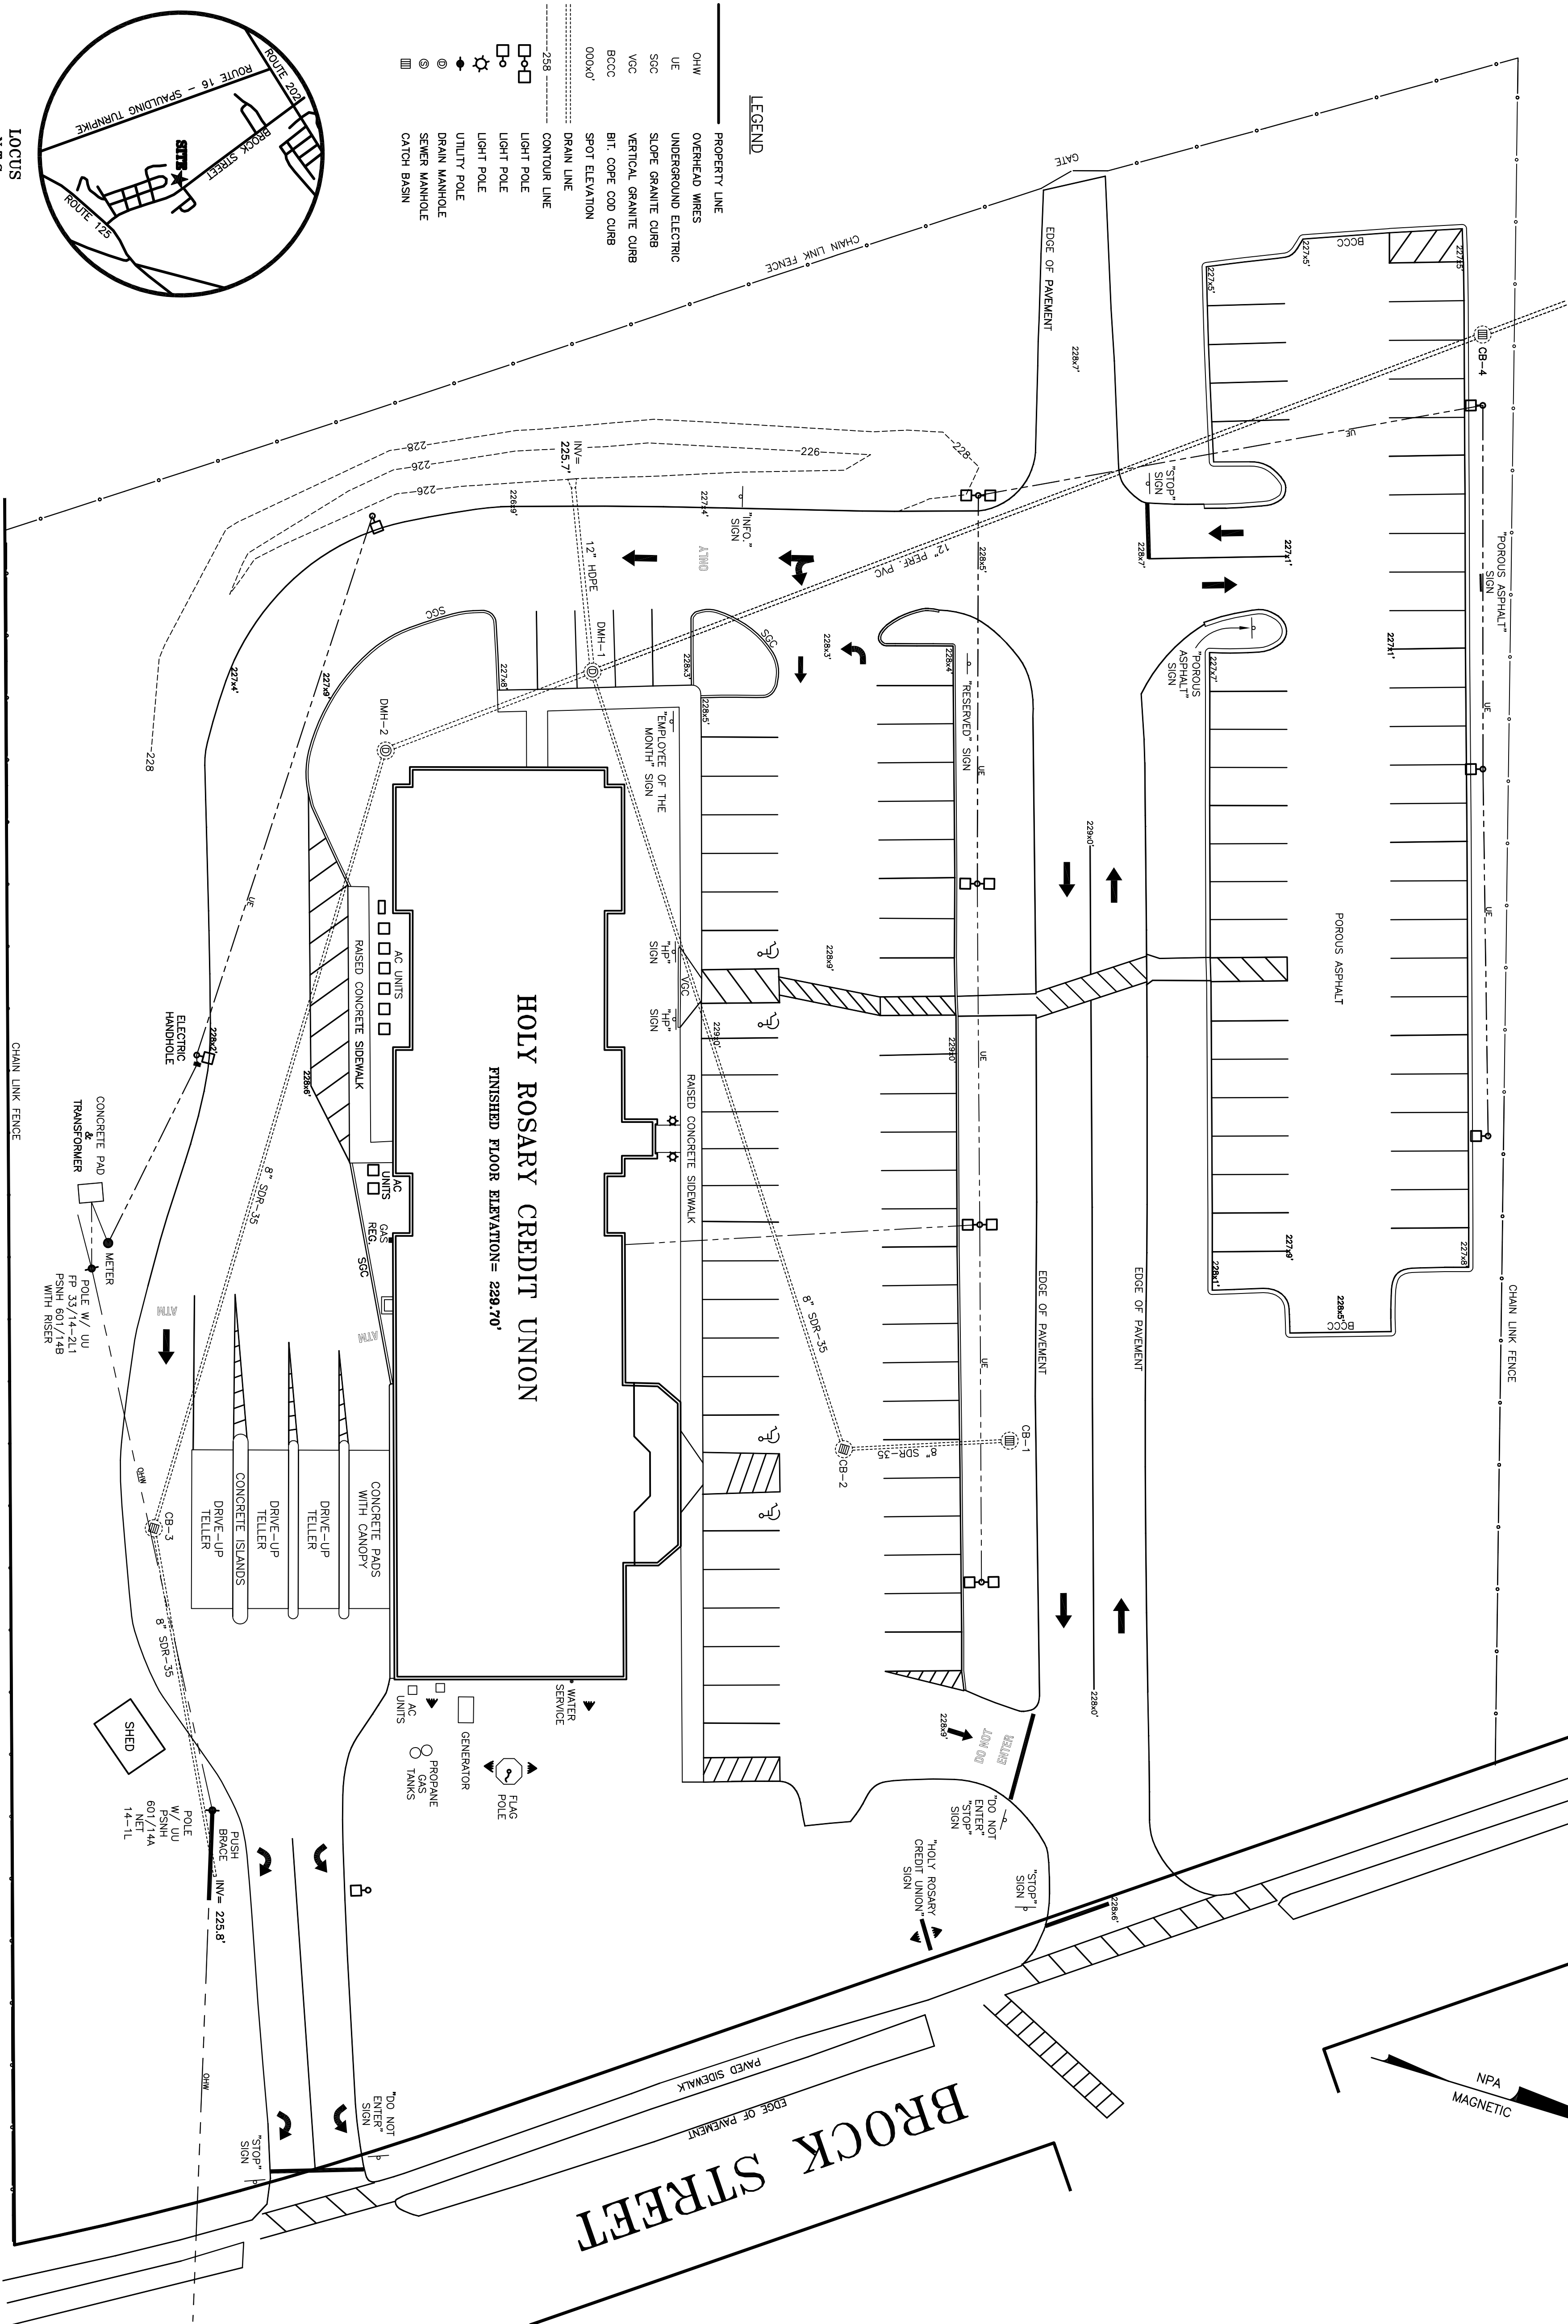


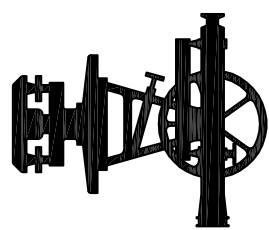


GENERAL NOTES

1. THE PURPOSE OF THIS PLAN IS TO SHOW THE AS-BUILT FEATURES OF THE SITE WITHIN THE REFERENCED PLAN.
2. ALL UNDERGROUND EXISTING UTILITY LOCATIONS ARE APPROXIMATE AND ARE NOT FIELD LOCATED. ALL CONTRACTORS SHALL VERIFY THEIR EXACT LOCATION PRIOR TO ANY FUTURE WORK BEING PERFORMED.
3. THIS PLAN SHOWS ONLY THOSE FEATURES THAT WERE VISUALLY APPARENT ON THE DATE OF SURVEY 07-05-11. THE ABSENCE OF SUBSURFACE STRUCTURES, UTILITIES, ETC. FROM THIS PLAN, BUT IN EXISTENCE, IS NOT INTENDED OR IMPLIED.

REFERENCE PLAN

"EXPANSION SITE PLAN, BROOK STREET, ROCHESTER, NH
FOR HOLY ROSARY CREDIT UNION"
DATED JANUARY 2010 BY NORWAY PLAINS ASSOCIATES, INC.
PLAN NO. C.2510 SP


CB-1	RM = 226.57'	INV. OUT = 221.8'
CB-2	RM = 228.11'	INV. OUT = 216.5'
CB-3	RM = 228.22'	INV. = 225.2'
CB-4	RM = 226.06'	INV. IN = 215.3'
DMH-1	RM = 227.98'	INV. OUT = 215.1'
DMH-2	RM = 228.56'	INV. TO DMH-2 = 222.5'
		INV. TO CB-2 = 215.4'
		INV. TO CB-3 = 222.5'
		INV. IN = 224.4'
		INV. IN = 224.0'

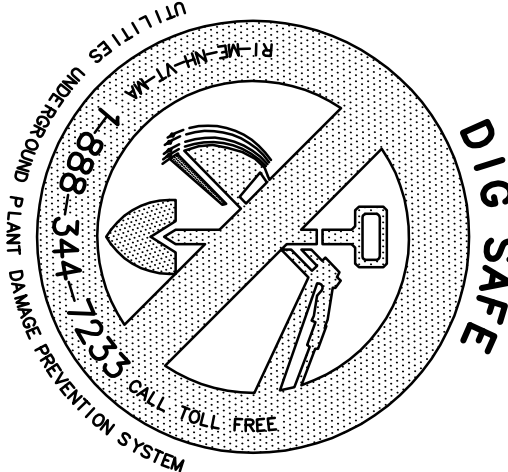

AS-BUILT SITE PLAN
133 BROOK STREET
ROCHESTER, NH
FOR HOLY ROSARY
CREDIT UNION

TAX MAP 129, LOT 01
OWNER OF RECORD:
HOLY ROSARY CREDIT UNION
P.O. BOX 2078
ROCHESTER, NH 03866-2078
S.C.R.D. BOOK 1818, PAGE 794

SCALE: 1" = 20' JULY 2011

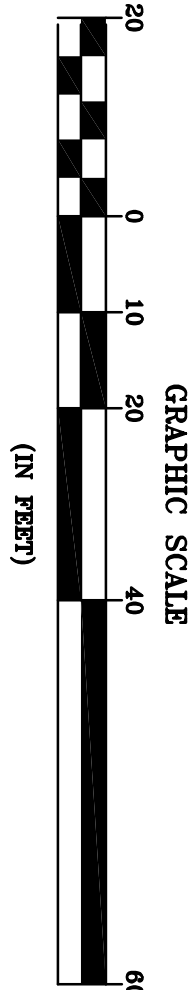

FILE NO. 237
PLAN NO. C-2510AB
DWG. NO. 09058/AB-1
F.B. NO. "93" 865"