


- GENERAL NOTES
1. THE PURPOSE OF THIS PLAN IS TO SHOW THE AS-BUILT FEATURES OF THE SITE WITHIN THE REFERENCED PLAN.
 2. ALL UNDERGROUND EXISTING UTILITY LOCATIONS ARE APPROXIMATE AND ARE NOT FIELD LOCATED. ALL CONTRACTORS SHALL VERIFY THEIR EXACT LOCATION PRIOR TO ANY FUTURE WORK BEING PERFORMED.
 3. THIS PLAN SHOWS ONLY THOSE FEATURES THAT WERE VISUALLY APPARENT ON THE DATE OF THE SURVEY, 07-12-11. THE ABSENCE OF SUBSURFACE STRUCTURES, UTILITIES, ETC. FROM THIS PLAN, BUT IN EXISTENCE, IS NOT INTENDED OR IMPLIED.

REFERENCE PLAN

"AMENDED SITE PLAN, WASHINGTON ST. - ROUTE 202, TAX MAP 250, LOT 32-1, ROCHESTER, NH FOR ROBERT L. HIGGINS"
DATED JUNE 2009 BY NORWAY PLAINS ASSOCIATES, INC.
PLAN NO. C-2011-SF7A

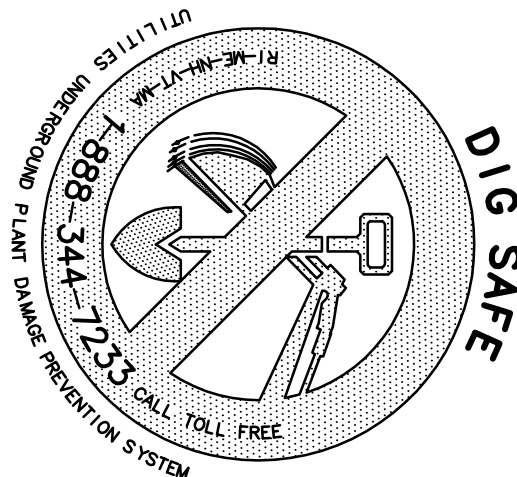

TAX MAP 250, LOT 32-1
TOTAL PARCEL AREA: 10.29 ACS.
OWNER OF RECORD:
ROBERT L. HIGGINS REVOCABLE LIVING TRUST
c/o ROBERT L. HIGGINS, TRUSTEE
PO BOX 849
ROCHESTER, NH 03866-0849
SCRD BK 3678, PG 0306




AS-BUILT SITE PLAN
WASHINGTON ST. - ROUTE 202
TAX MAP 250, LOT 32-1
ROCHESTER, N.H.

FOR

ROBERT L. HIGGINS

SCALE: 1"= 50' AUGUST 2011

GRAPHIC SCALE

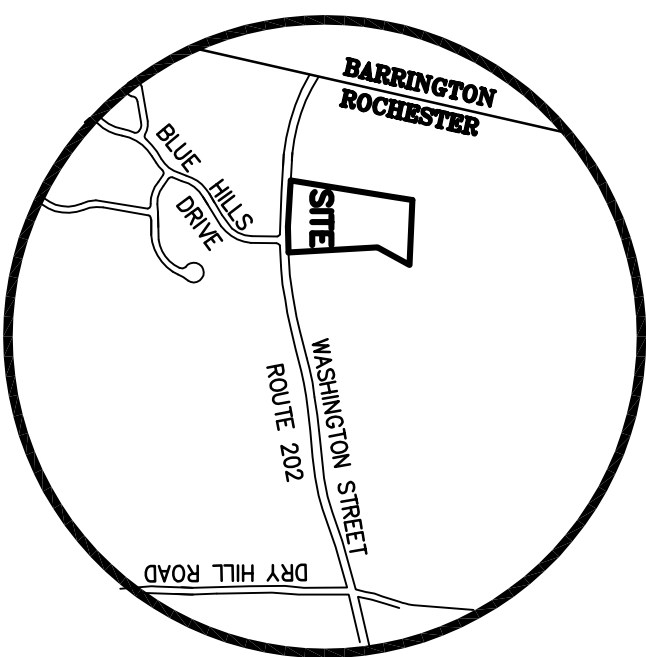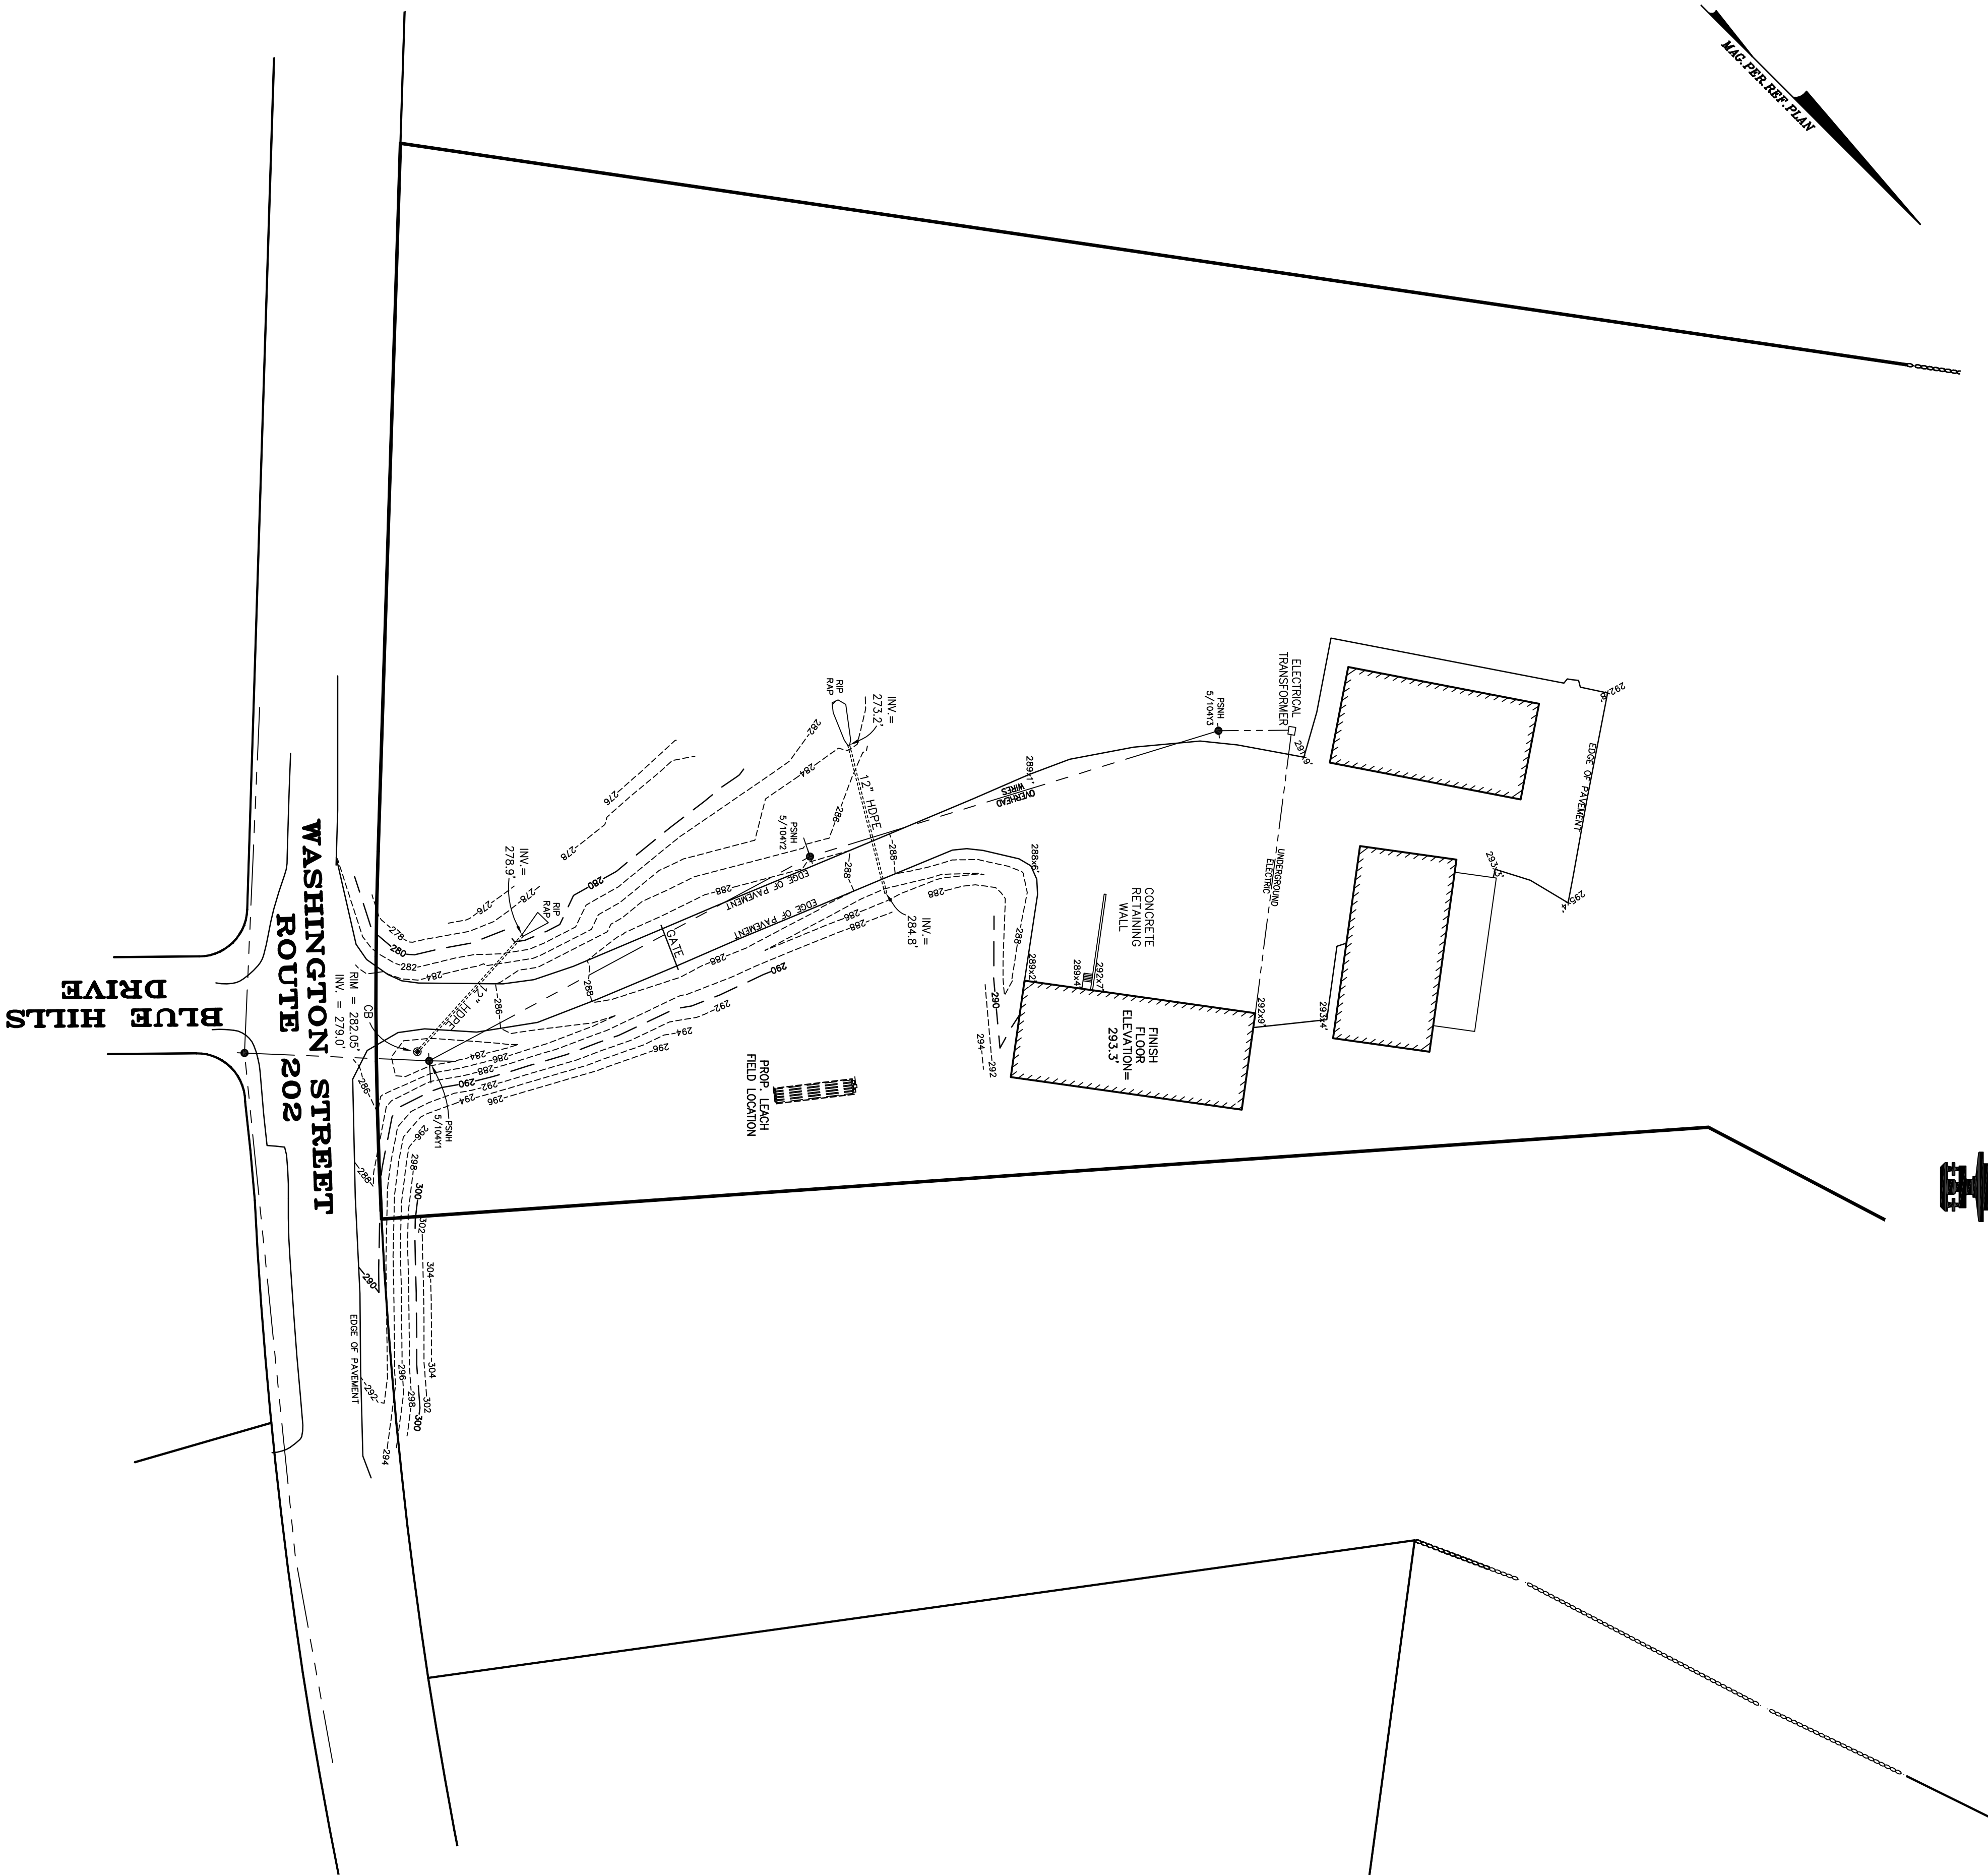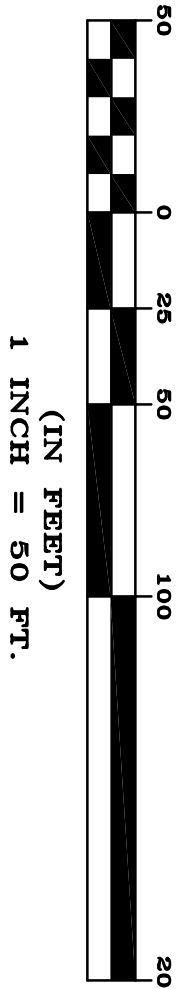

LOCUS
N.T.S

FILE NO. 144
PLAN NO. C-2011-AB
DWG. NO. 05176/AB-1
F.B. NO. "93" CRK